

**TOWN OF PARADISE  
ONSITE WASTEWATER MANAGEMENT ZONE  
5555 SKYWAY PARADISE CA**

Date of Issue: 1/29/2018

**ONSITE WASTEWATER DISPOSAL SYSTEM OPERATING PERMIT**

**Owner:** Brown Marilyn L  
6291 Harvey Rd  
Paradise, CA 95969

**Permit Number:** OS18-00236  
**AP Number:** 051-172-036-000  
**Property Address:** 6291 HARVEY RD  
**Expiration Date:** 1/8/2025

Structure(s) served by this onsite wastewater disposal system: Two (2) Bedroom - Residential  
Onsite wastewater disposal system daily design flow: 225 gallons per day.  
Evaluation/Construction inspection was performed on: 01/08/2018

**EXISTING SYSTEM COMPONENTS**

Standard - - Residential

**Tank Details**

<b>Installation Date</b>	<b>Material</b>	<b>Liquid Capacity</b>	<b>Type</b>
01/20/1961	Concrete	1000 Gallons	Septic

**Absorption Field**

<b>Installation Date</b>	<b>Total Length</b>	<b>Trench Width</b>	<b>Total Rock</b>
09/10/2009	113 Feet	24 Inches	24 Inches

Operating Permit Notes: RES OP - 2BDRM

**Evaluator/Inspector:**  
ERIC HEGENBART  
HEGENBART SEPTIC TANK CLEANING  
530 877 8261

**Certificate/License Number:**  
S-109

Additional onsite wastewater disposal system evaluations are required if there are any changes in the onsite system operating parameters.

**This permit is valid until 1/8/2025.**

The owner is responsible for having an evaluation performed within three months before this date in order to have this operating permit renewed.

Date: 1/29/2018

Signature: 


Town of Paradise  
OS# 09-03091  
APPROVED  
By: BC  
Date: 9/8/09  
Onsite Division




U.S.A. TO BE MARKED  
PRIOR TO EXCAVATION

1"=20' SCALED AS-BUILT TO BE  
PROVIDED AT TIME OF INSPECTION

6291 HARVEY RD

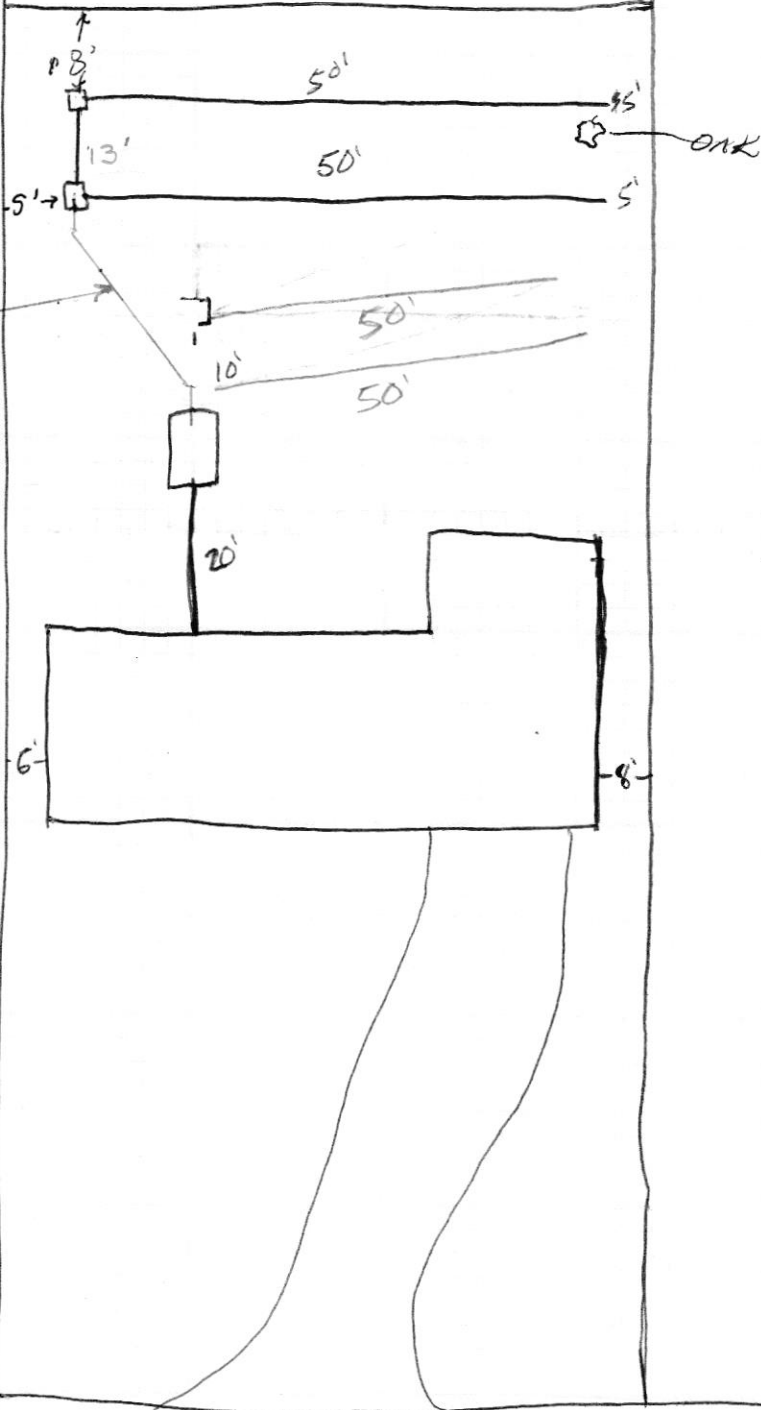

APN 051-172-036-000  
SITE 6291 Harvey Rd  
MAX # BDRMS 2  
MAX SQ FT 200

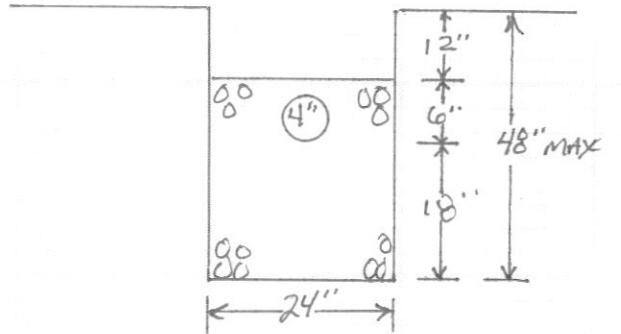

TRENCH DETAIL

HARVEY RD