



**WEISENHAUS
ARCHITECTURE**

5349 S. CRENSHAW BLVD., SUITE #101
LOS ANGELES, CA 90043
310-365-2724 duane@weisenhausarch.com

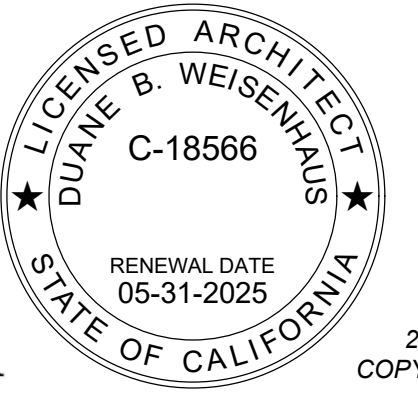

WA

2024
COPYRIGHT

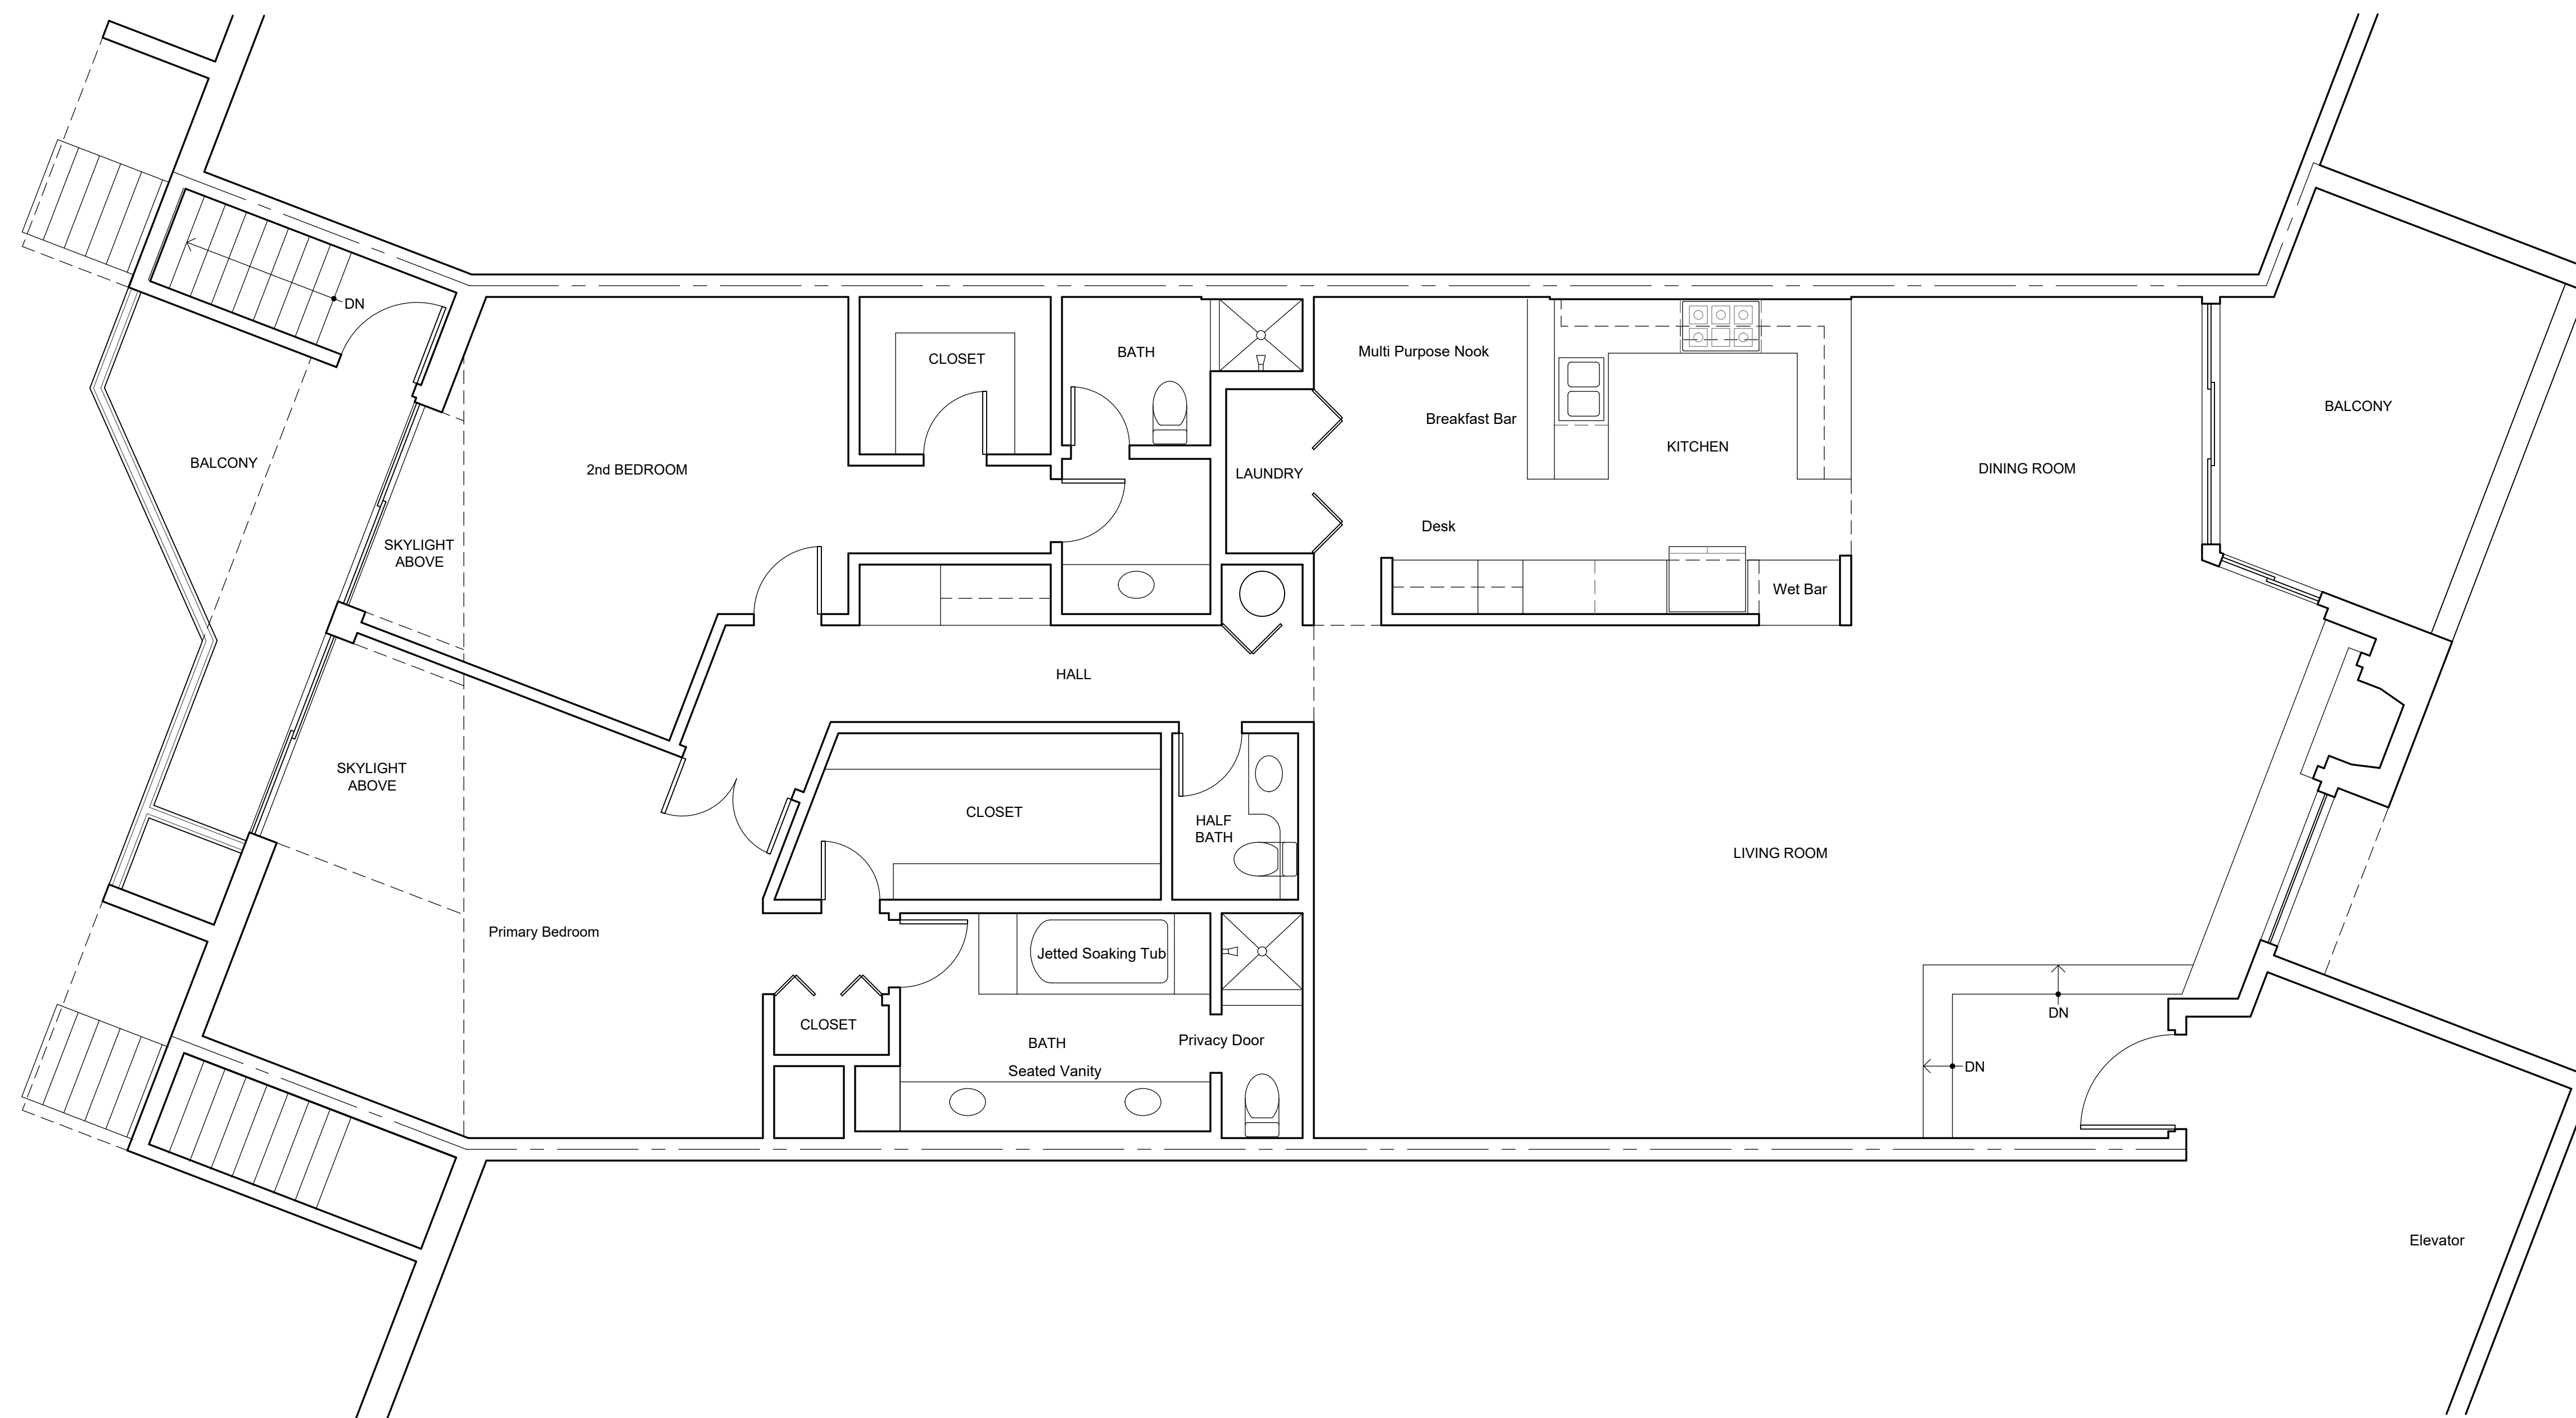

ISSUANCE		
NO.	DESCRIPTION	DATE
1	AS-BUILT PLANS	5-23-2024

**11687 BELLAGIO
UNIT #12
CONDOMINIUM**

11687 BELLAGIO ROAD
LOS ANGELES, CA 90049

**AS-BUILT
FLOOR PLAN**

AS-BUILT FLOOR PLAN

SCALE
1/4" = 1'-0" 1