
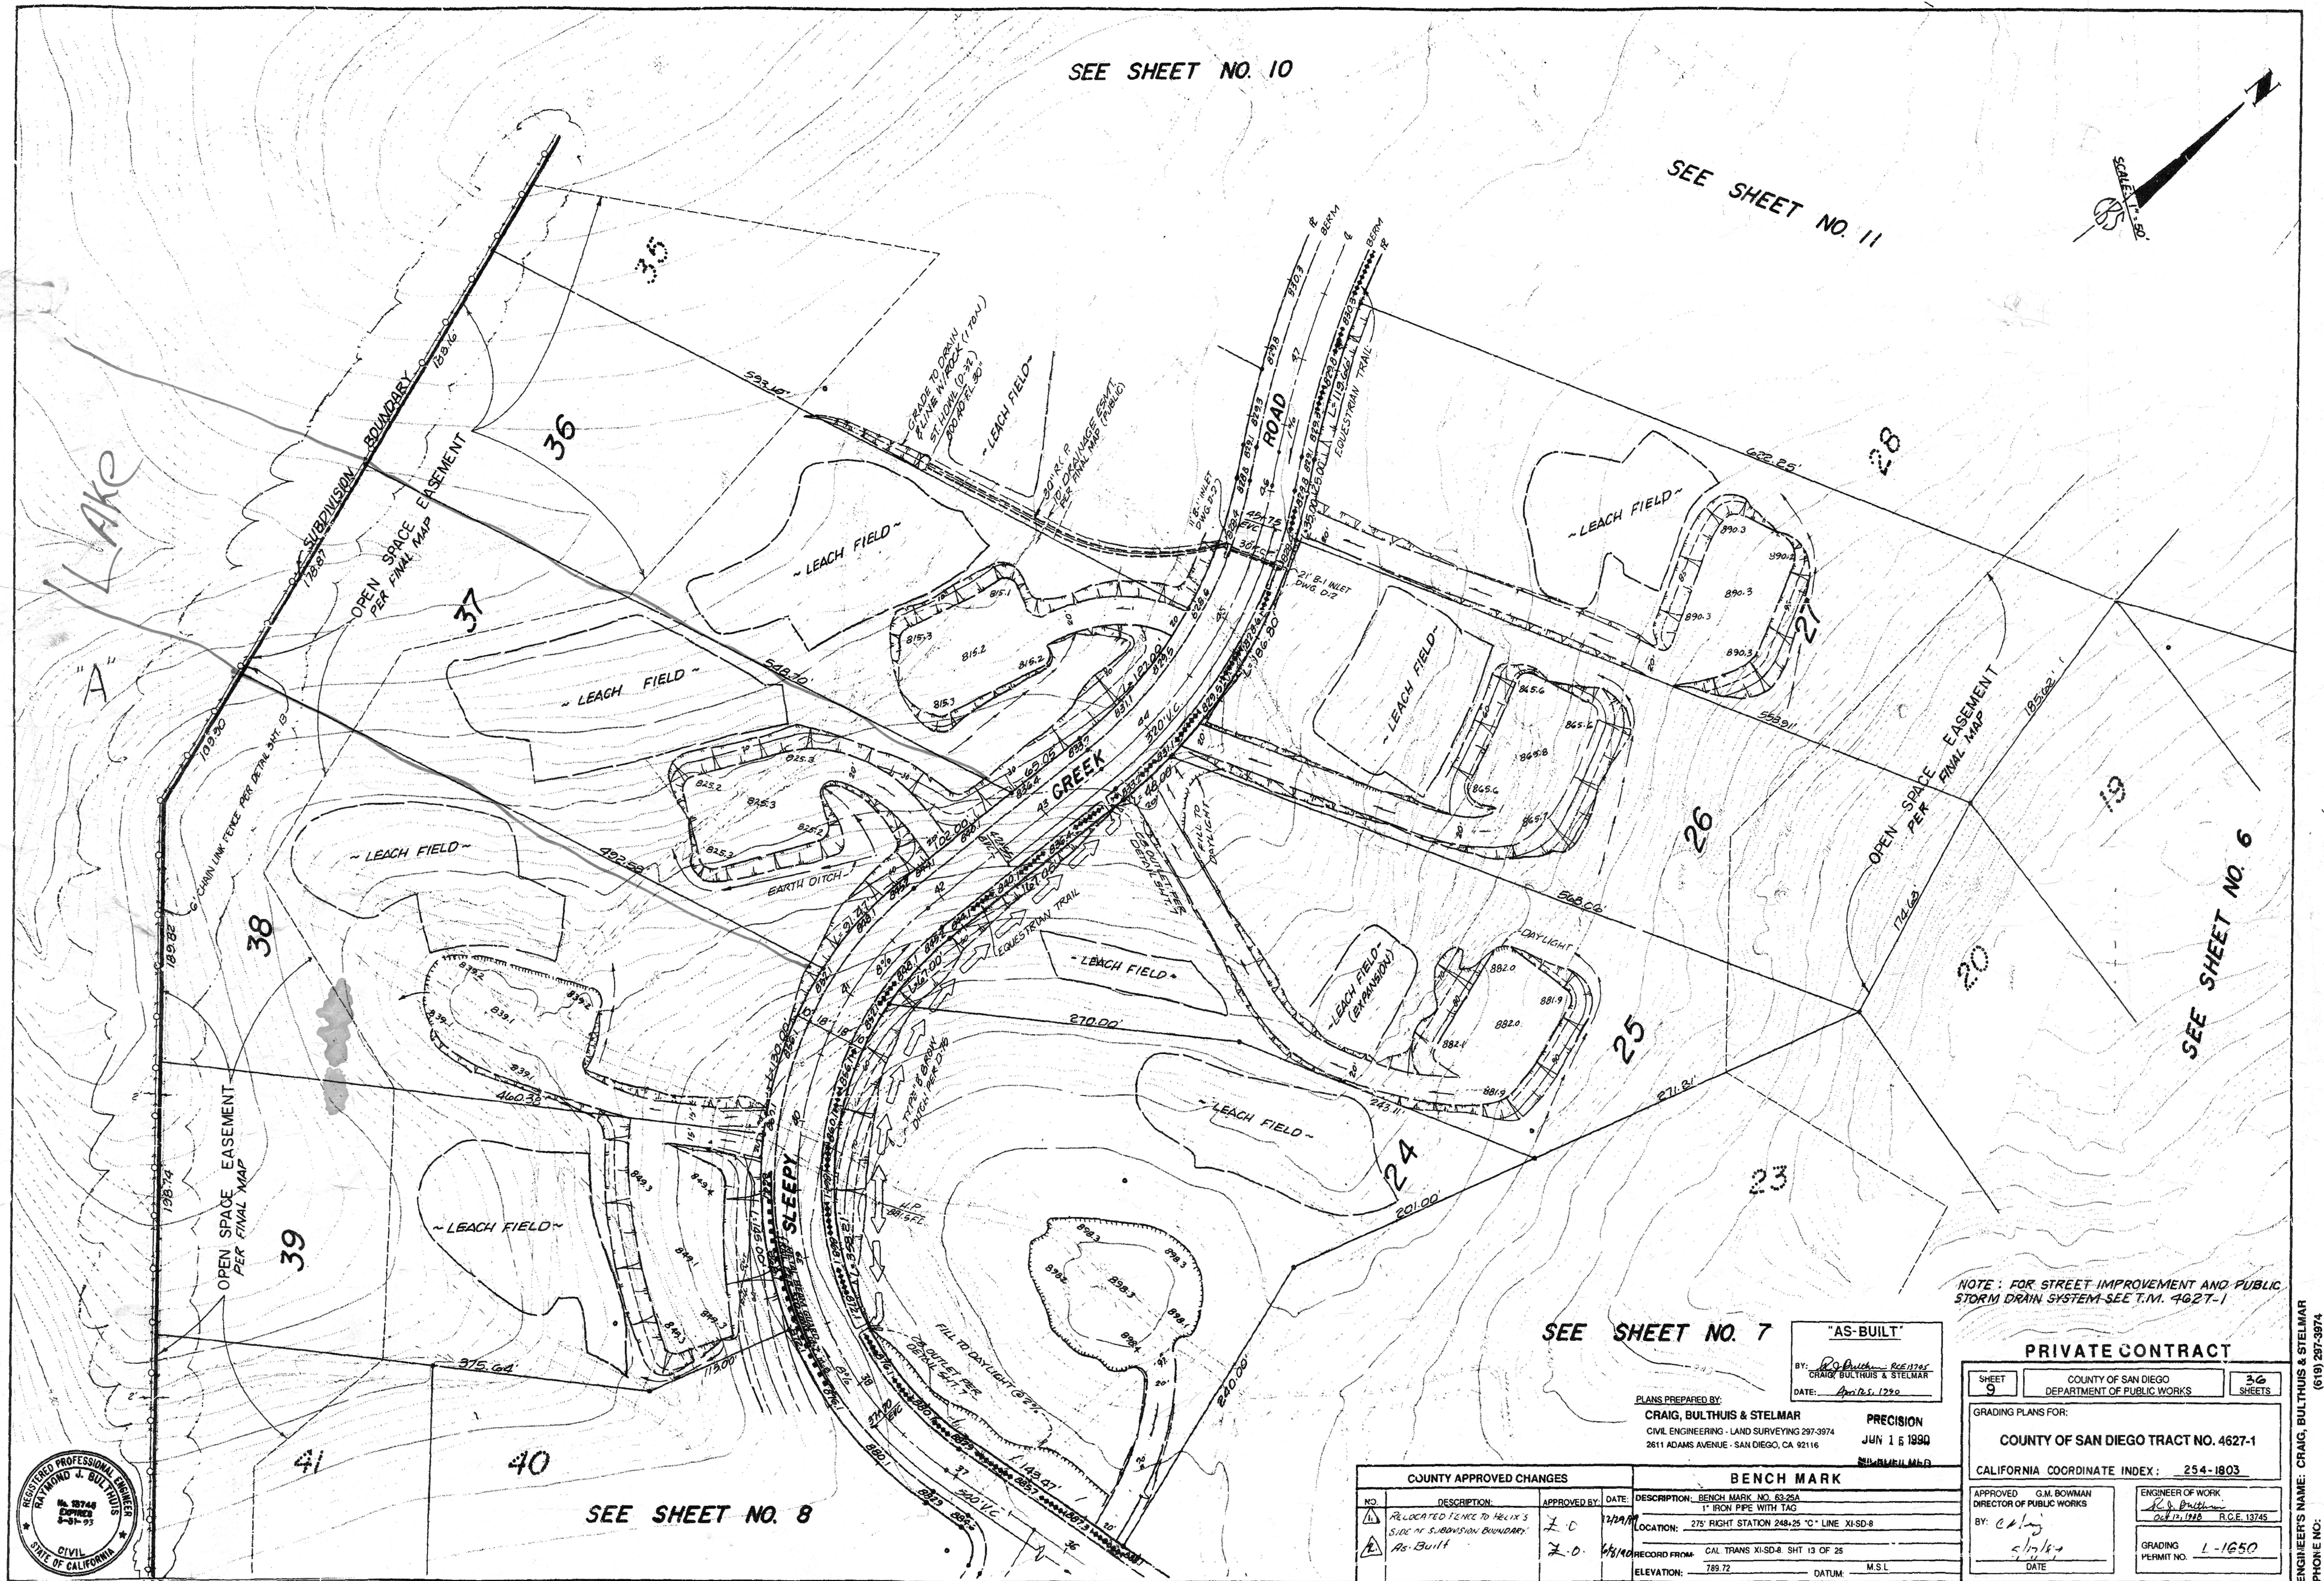


SEE SHEET NO. 10

SEE SHEET NO. 11

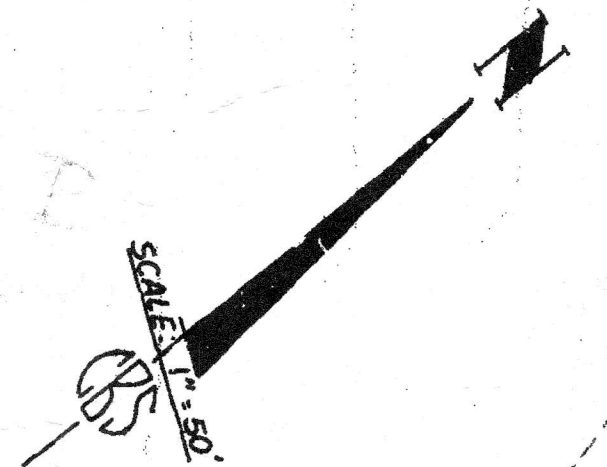

SEE SHEET NO. 6

SEE SHEET NO. 8

SEE SHEET NO. 7

NOTE: FOR STREET IMPROVEMENT AND PUBLIC STORM DRAIN SYSTEM SEE T.M. 4627-1



PLANS PREPARED BY:
CRAIG, BULTHUIS & STELMAR
CIVIL ENGINEERING - LAND SURVEYING 297-3974
2611 ADAMS AVENUE - SAN DIEGO, CA 92116

"AS-BUILT"
BY: *R. Bulthuis* RCE 1705
CRAIG, BULTHUIS & STELMAR
DATE: April 15, 1990

PRECISION
JUN 1 5 1990
MILWAUKEE MFG

COUNTY APPROVED CHANGES				BENCH MARK	
NO.	DESCRIPTION	APPROVED BY	DATE	DESCRIPTION	DATE
1	RELOCATED FENCE TO HELIX'S SIDE OF SUBDIVISION BOUNDARY.	<i>L.C.</i>	7/29/90	BENCH MARK NO. 6326A	
2	As-Built	<i>L.C.</i>	7/29/90	1" IRON PIPE WITH TAG	
				LOCATION: 275' RIGHT STATION 248+25 "C" LINE XI-SD-8	
				RECORD FROM: CAL TRANS XI-SD-8, SHT 13 OF 25	
				ELEVATION: 789.72 DATUM: M.S.L.	

PRIVATE CONTRACT	
SHEET 9	COUNTY OF SAN DIEGO DEPARTMENT OF PUBLIC WORKS
GRADING PLANS FOR: COUNTY OF SAN DIEGO TRACT NO. 4627-1	
CALIFORNIA COORDINATE INDEX: 254-1803	
APPROVED: G.M. BOWMAN DIRECTOR OF PUBLIC WORKS	ENGINEER OF WORK: <i>R. Bulthuis</i> RCE 1705
BY: <i>C. Long</i>	GRADING PERMIT NO. L-1650
DATE: 5/17/90	

ENGINEER'S NAME: CRAIG, BULTHUIS & STELMAR
PHONE NO: (619) 297-3974