

**TOWN OF PARADISE
ONSITE WASTEWATER MANAGEMENT ZONE
5555 SKYWAY PARADISE CA**

Date of Issue: 4/11/2016

ONSITE WASTEWATER DISPOSAL SYSTEM OPERATING PERMIT

FILE COPY

Owner: Edwards Jerry & Linda
1042 Central Park Dr
Paradise, CA 95969

Permit Number: OS16-01258
AP Number: 053-131-039-000
Property Address: 5805 COPELAND RD
Expiration Date: 10/23/2016

Structure(s) served by this onsite wastewater disposal system: Three (3) Bedroom - Residential
Onsite wastewater disposal system daily design flow: 300.00 gallons per day.
Evaluation/Construction inspection was performed on: 10/23/2014

EXISTING SYSTEM COMPONENTS

Standard - Tank - Residential

Tank Details

Installation Date	Material	Liquid Capacity	Type
10/23/2014	Concrete	1500 Gallons	Septic

Absorption Field

Installation Date	Total Length	Trench Width	Total Rock
09/25/1964	125 Feet	24 Inches	12 Inches

Operating Permit Notes: RES OP - THREE (3) BEDROOM

Evaluator/Inspector:
BOB LARSON
TOWN OF PARADISE
872-6297

Certificate/License Number:
S-101

Additional onsite wastewater disposal system evaluations are required if there are any changes in the onsite system operating parameters.

This permit is valid until 10/23/2016.

The owner is responsible for having an evaluation performed within three months before this date in order to have this operating permit renewed.

Date: 4/11/2016

Signature:



Town of Paradise
OS# 14-04193
APPROVED
By: BL
Date: 10/13/14
Onsite Division


FILE COPY

1" = 20' SCALED AS-BUILT TO BE
PROVIDED AT TIME OF INSPECTION

U.S.A. TO BE MARKED
PRIOR TO EXCAVATION

- * Abandon existing
septic tank w/ slurry.
- * Install new 1500
Traffic rated septic
tank.
- * Tie into existing leach
line.

AS-Built

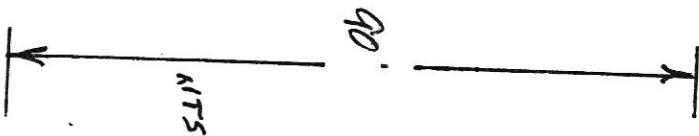

APN 053-131-039-000
SITE 5805 Copeland Rd
MAX # BDRMS 3
MAX SQ FT 2900

