


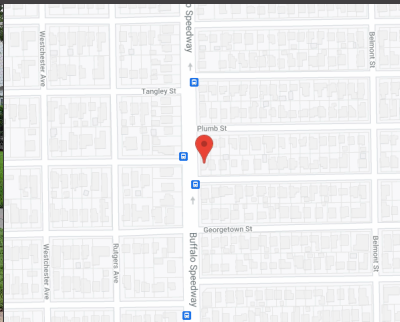


PROPERTY ADDRESS:
3136 LAFAYETTE STREET, HOUSTON, TEXAS 77005

SURVEY NUMBER: TX2107.7261

DATE OF SURVEY: 08/02/21 **FIELD WORK DATE:** 7/30/2021

REVISION DATE(S):
(REV.1 8/2/2021)

POINTS OF INTEREST
NONE VISIBLE

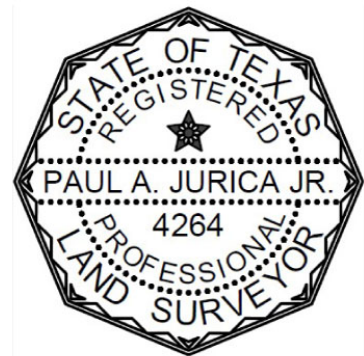

Paul A. Jurica Jr.

SURVEYORS CERTIFICATE

The undersigned, being a Registered Professional Land Surveyor in the State of Texas, does hereby certify that the Plat or Survey hereon correctly represents the results of an actual survey made on the ground under my direction and meets the standards of practice promulgated by the Texas Board of Professional Engineers and Land Surveyors.




Headquarter's Office
o: 866.735.1916 | f: 866.744.2882
1955 Lakeway Drive, Ste 220 | Lewisville, TX 75057
Firm No: 10063800


Branch Office
o: 866.735.1916 | f: 866.744.2882
11111 Richmond Ave, Suite 150 | Houston, TX 77082
Firm No: 10194357



www.exactaland.com | office: 866.735.1916 | fax: 866.744.2882

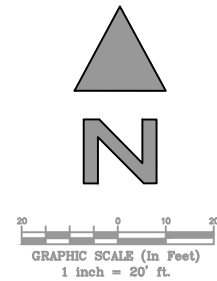

BUFFALO SPEEDWAY (100' R/W)

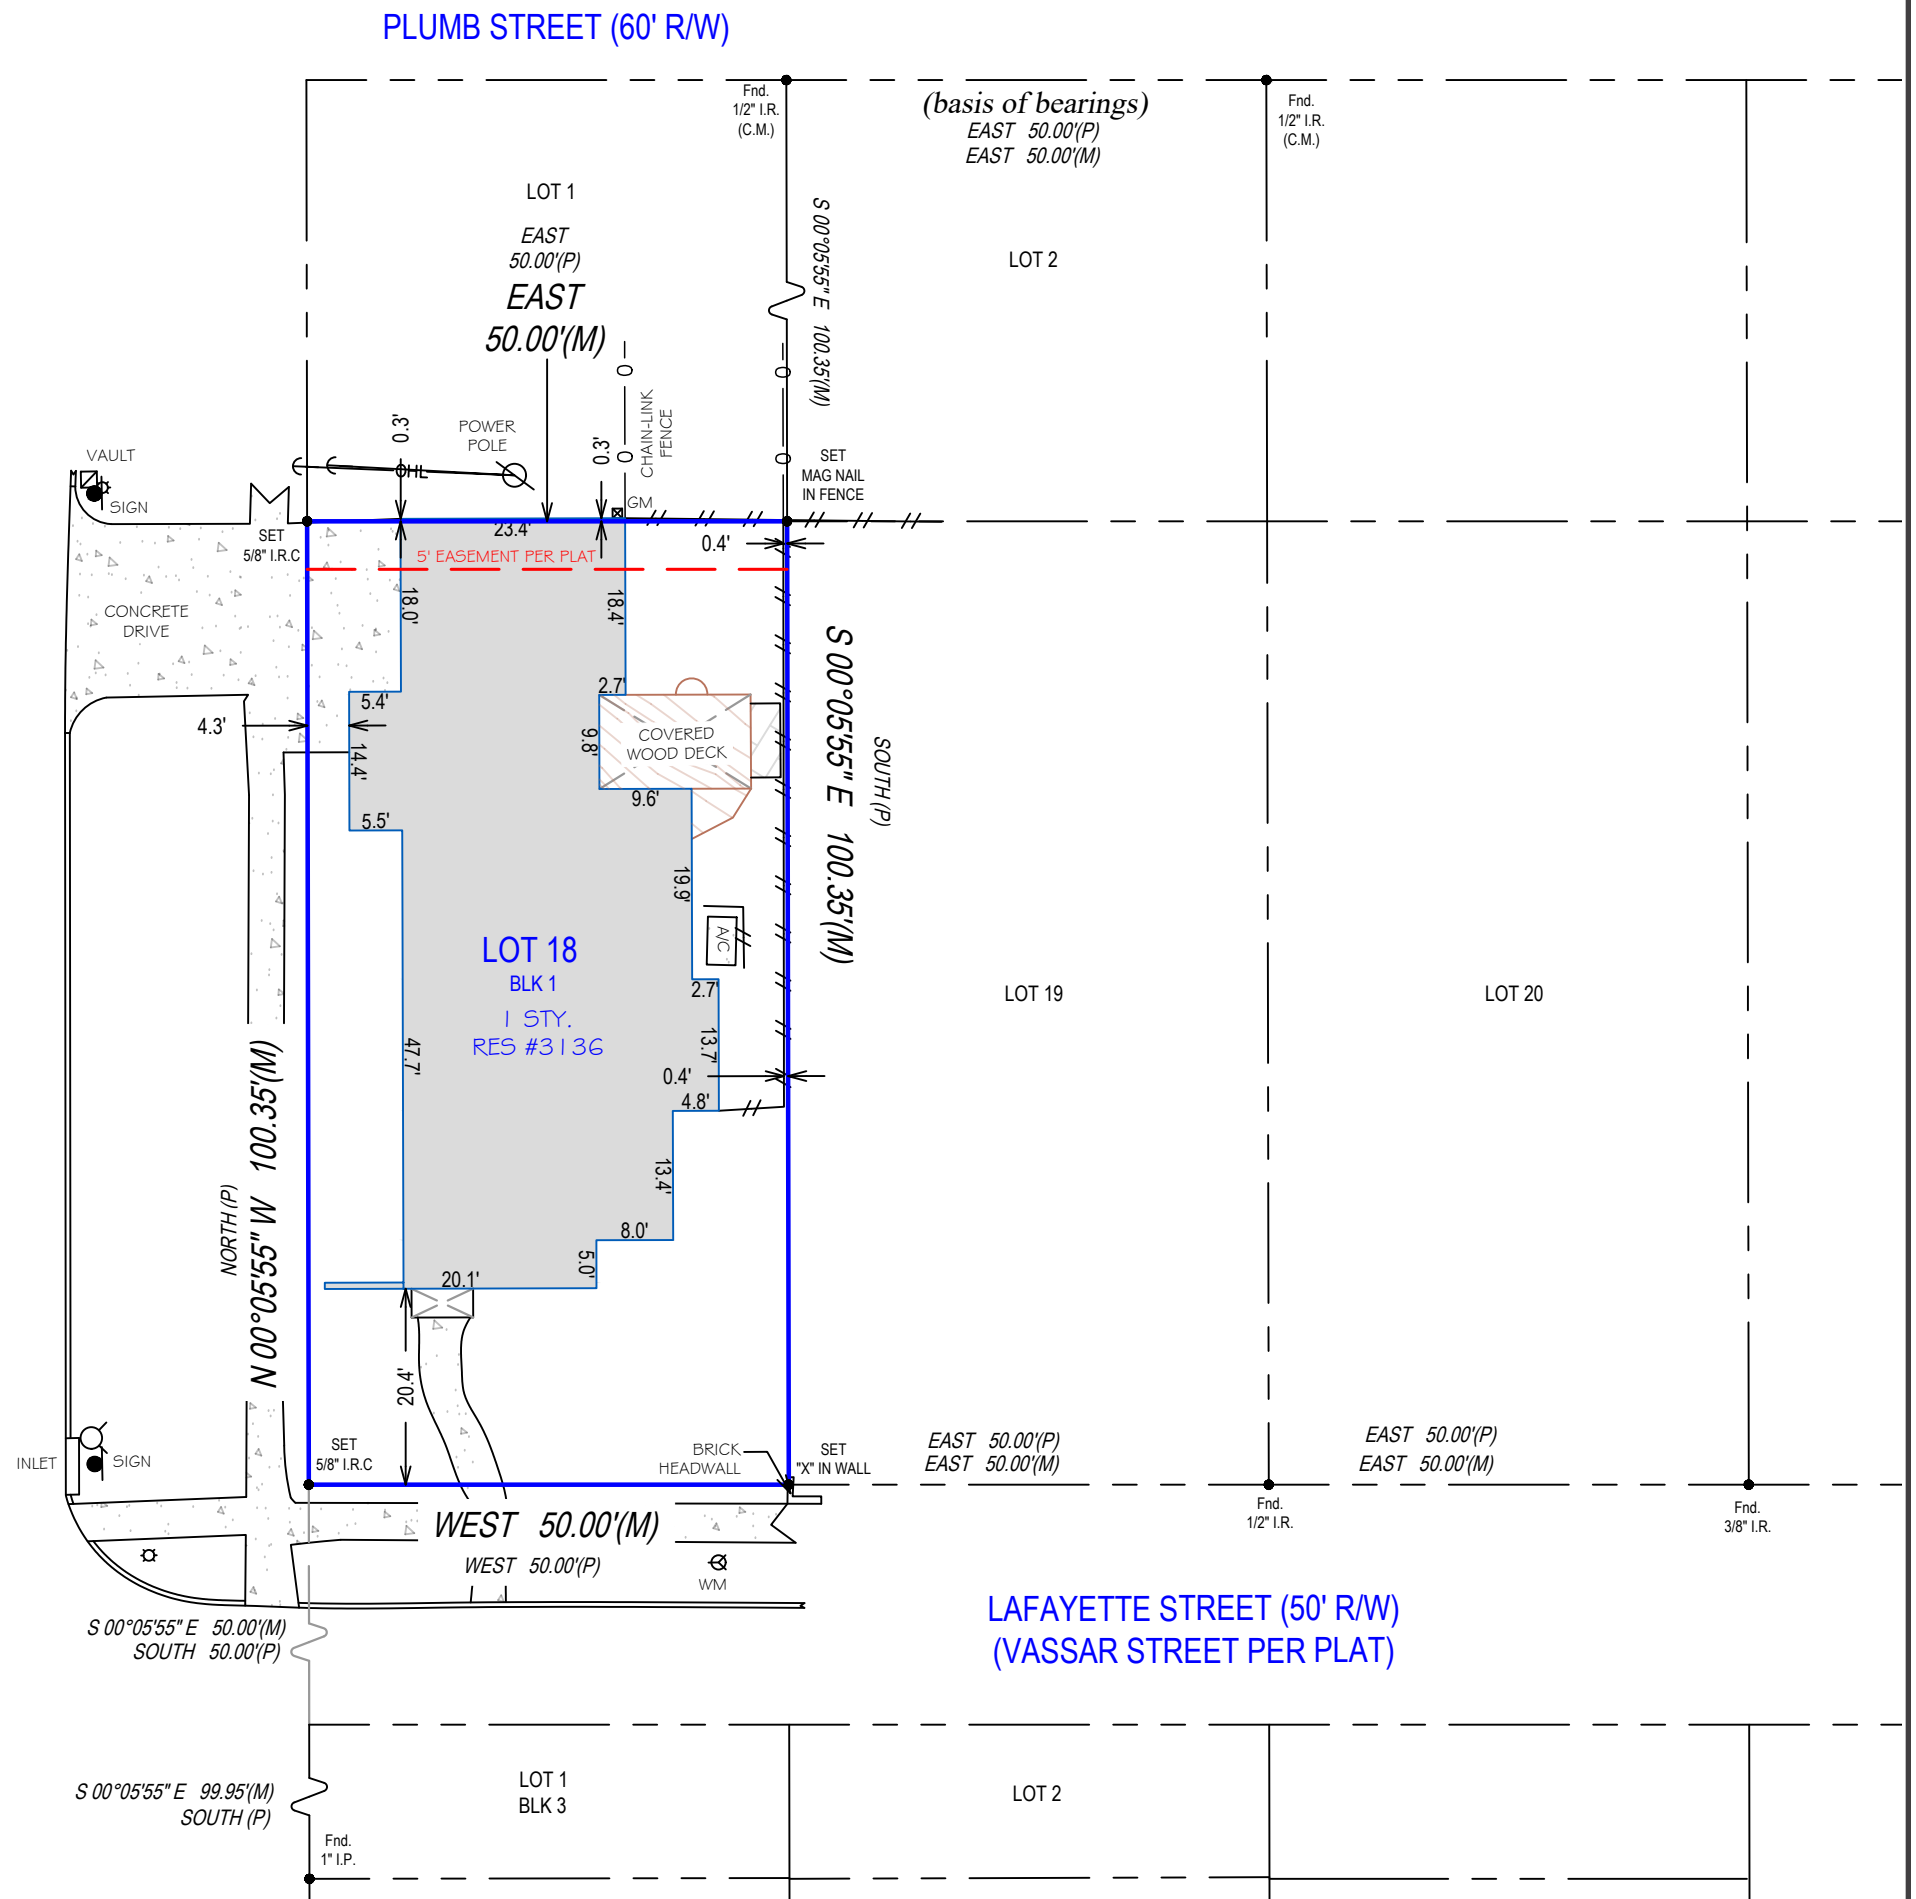

SEE PAGE 2 OF 2 FOR LEGAL DESCRIPTION
PAGE 1 OF 2 - NOT VALID WITHOUT ALL PAGES

PROPERTY ADDRESS:
3136 LAFAYETTE STREET, HOUSTON, TEXAS 77005

SURVEY NUMBER: TX2107.7261

CERTIFIED TO:
REDFINOW BORROWER LLC; TITLE FORWARD; WESTCOR LAND TITLE INSURANCE COMPANY

DATE OF SURVEY: 08/02/21

BUYER: REDFINOW BORROWER LLC

LENDER:

TITLE COMPANY: TITLE FORWARD

TITLE COMMITMENT:

CLIENT FILE NO: TX-44592

LEGAL DESCRIPTION:
LOT EIGHTEEN (18), IN BLOCK ONE (1) OF RICE COURT, A SUBDIVISION IN HARRIS COUNTY, TEXAS, ACCORDING TO THE MAP OR PLAT THEREOF RECORDED IN VOLUME 7, PAGE 47, OF THE MAP RECORDS OF HARRIS COUNTY, TEXAS.

FLOOD ZONE INFORMATION:
BY PERFORMING A SEARCH WITH THE LOCAL GOVERNING MUNICIPALITY OR WWW.FEMA.GOV, THE PROPERTY APPEARS TO BE LOCATED IN ZONE X SHADED, PER 480318 0860L, DATED: 06/18/2007.

- GENERAL SURVEYORS NOTES:
1. Unless otherwise noted, the Legal Description used to perform this survey was supplied by others. This survey does not determine nor imply ownership. Unless otherwise noted, an examination of the abstract of title was NOT performed by the signing surveyor to determine which instruments, if any, are affecting this property.

2. The purpose of this survey is to establish the boundary of the lands described by the legal description provided and to depict the visible improvements thereon for a pending financial transaction. Underground footings, utilities, or other service lines, including roof eave overhangs were not located as part of this survey. Unless specifically stated otherwise the purpose and intent of this survey is not for any construction activities or future planning.

3. Controlling Monuments (“CM”) designated on the survey indicate the corners found or recovered and are the basis of the referenced bearing for this survey. Unless otherwise noted the bearings depicted hereon are based on the record map or plat.

4. If there is a septic tank or drain field shown on this survey, the location depicted hereon was either shown to the surveyor by a third party or it was estimated by visual above ground inspection only. No excavation was performed to determine its location.

5. This survey is exclusively for a pending financial transaction and only to be used by the parties to whom it is certified.

6. Alterations to this survey map and report by other than the signing surveyor are prohibited.

7. Any FEMA flood zone data contained on this survey is for informational purposes only. Research to obtain said data was performed at www.fema.gov and may not reflect the most recent information.

8. Unless otherwise noted “SIRC” indicates a Set Iron Rebar with Cap stamped LB# 10063800 or LB# 10194357, a minimum half inch in diameter and eighteen inches long.

9. If you are reading this survey in an electronic format, the information contained on this document is only valid if this document is electronically signed as specified in Texas State Statutes 663.18. The Electronic Signature File related to this document is prominently displayed on the invoice for this survey which is sent under separate cover. Manually signed and sealed logs of all survey signature files are kept in the office of the performing surveyor.

10. The symbols reflected in the surveyor’s legend and on this survey may have been enlarged or reduced for clarity. The symbols have been plotted at the approximate center of the field location and may not represent the actual shape or size of the feature.

11. Points of Interest (POI’s) are select above-ground improvements, which may appear in conflict with boundary, building setback or easement lines, as defined by the parameters of this survey. These POI’s may not represent all items of interest to the viewer. There may be additional POI’s which are not shown or called-out as POI’s, or which are otherwise unknown to the surveyor.

12. Utilities shown on the subject property may or may not indicate the existence of recorded or unrecorded utility easements.

13. The information contained on this survey has been performed exclusively by and is the sole responsibility of Exacta Land Surveyors, LLC. Additional logos or references to third party firms are for informational purposes only.

14. Due to varying construction standards, house dimensions are approximate and are not intended to be used for new construction or planning. Dimensions are in feet and decimals thereof.

SURVEYORS LEGEND:																																											
<table><tr><th>LINETYPES</th><td></td></tr><tr><td></td><td>Boundary Line</td></tr><tr><td></td><td>Center Line</td></tr><tr><td></td><td>Chain Link or Wire Fence</td></tr><tr><td></td><td>Easement</td></tr><tr><td></td><td>Edge of Water</td></tr><tr><td></td><td>Iron Fence</td></tr><tr><td></td><td>Overhead Lines</td></tr><tr><td></td><td>Structure</td></tr><tr><td></td><td>Survey Tie Line</td></tr><tr><td></td><td>Vinyl Fence</td></tr><tr><td></td><td>Wall or Party Wall</td></tr><tr><td></td><td>Wood Fence</td></tr></table>	LINETYPES			Boundary Line		Center Line		Chain Link or Wire Fence		Easement		Edge of Water		Iron Fence		Overhead Lines		Structure		Survey Tie Line		Vinyl Fence		Wall or Party Wall		Wood Fence	ABBREVIATIONS (C) - Calculated (D) - Deed (F) - Field (M) - Measured (P) - Plat (S) - Survey A/C - Air Conditioning AE - Access Easement ANE - Anchor Easement ASBL - Accessory Setback Line B/W - Bay/Box Window BC - Block Corner BFP - Backflow Preventer BLDG - Building BLK - Block BM - Benchmark BR - Bearing Reference BRL - Building Restriction Line BSMT - Basement C - Curve C/L - Center Line C/P - Covered Porch C/S - Concrete Slab CATV - Cable TV Riser CB - Concrete Block CH - Chord Bearing CHIM - Chimney CLF - Chain Link Fence CME - Canal Maintenance Easement CO - Clean Out CONC - Concrete COR - Corner CS/W - Concrete Sidewalk CUE - Control Utility Easement CVG - Concrete Valley Gutter D/W - Driveway DE - Drainage Easement DF - Drain Field DH - Drill Hole DUE - Drainage & Utility Easement ELEV - Elevation EM - Electric Meter ENCL - Enclosure ENT - Entrance EOP - Edge of Pavement EOW - Edge of Water ESMT - Easement EUB - Electric Utility Box F/DH - Found Drill Hole FCM - Found Concrete Monument FF - Finished Floor FIP - Found Iron Pipe																
LINETYPES																																											
	Boundary Line																																										
	Center Line																																										
	Chain Link or Wire Fence																																										
	Easement																																										
	Edge of Water																																										
	Iron Fence																																										
	Overhead Lines																																										
	Structure																																										
	Survey Tie Line																																										
	Vinyl Fence																																										
	Wall or Party Wall																																										
	Wood Fence																																										
<table><tr><th>SURFACE TYPES</th><td></td></tr><tr><td></td><td>Asphalt</td></tr><tr><td></td><td>Brick or Tile</td></tr><tr><td></td><td>Concrete</td></tr><tr><td></td><td>Covered Area</td></tr><tr><td></td><td>Water</td></tr><tr><td></td><td>Wood</td></tr></table>	SURFACE TYPES			Asphalt		Brick or Tile		Concrete		Covered Area		Water		Wood	SYMBOLS <table><tr><td></td><td>Benchmark</td></tr><tr><td></td><td>Center Line</td></tr><tr><td></td><td>Central Angle or Delta</td></tr><tr><td></td><td>Common Ownership</td></tr><tr><td></td><td>Control Point</td></tr><tr><td></td><td>Catch Basin</td></tr><tr><td></td><td>Elevation</td></tr><tr><td></td><td>Fire Hydrant</td></tr><tr><td></td><td>Find or Set Monument</td></tr><tr><td></td><td>Guywire or Anchor</td></tr><tr><td></td><td>Manhole</td></tr><tr><td></td><td>Tree</td></tr><tr><td></td><td>Utility or Light Pole</td></tr><tr><td></td><td>Well</td></tr></table>		Benchmark		Center Line		Central Angle or Delta		Common Ownership		Control Point		Catch Basin		Elevation		Fire Hydrant		Find or Set Monument		Guywire or Anchor		Manhole		Tree		Utility or Light Pole		Well
SURFACE TYPES																																											
	Asphalt																																										
	Brick or Tile																																										
	Concrete																																										
	Covered Area																																										
	Water																																										
	Wood																																										
	Benchmark																																										
	Center Line																																										
	Central Angle or Delta																																										
	Common Ownership																																										
	Control Point																																										
	Catch Basin																																										
	Elevation																																										
	Fire Hydrant																																										
	Find or Set Monument																																										
	Guywire or Anchor																																										
	Manhole																																										
	Tree																																										
	Utility or Light Pole																																										
	Well																																										

FIPC - Found Iron Pipe & Cap FIR - Found Iron Rod FIRC - Found Iron Rod & Cap FN - Found Nail FN&D - Found Nail & Disc FRRSPK - Found Rail Road Spike GAR - Garage GM - Gas Meter ID - Identification IE/EE - Ingress/Egress Easement ILL - Illegible INST - Instrument INT - Intersection IRRE - Irrigation Easement L - Length LAE - Limited Access Easement LB# - License No. (Business) LBE - Limited Buffer Easement LE - Landscape Easement LME - Lake/Landscape Maintenance Easement LS# - License No. (Surveyor) MB - Map Book ME - Maintenance Easement MES - Mitered End Section MF - Metal Fence MH - Manhole NR - Non-Radial NTS - Not to Scale NAVD88 - North American Vertical Datum 1988 NGVD29 - National Geodetic Vertical Datum 1929 OG - On Ground ORB - Official Records Book ORV - Official Record Volume O/A - Overall O/S - Offset OFF - Outside Subject Property OH - Overhang OHL - Overhead Utility Lines ON - Inside Subject Property P/E - Pool Equipment PB - Plat Book PC - Point of Curvature PCC - Point of Compound Curvature PCP - Permanent Control Point PI - Point of Intersection PLS - Professional Land Surveyor PLT - Planter POB - Point of Beginning POC - Point of Commencement PRC - Point of Reverse Curvature PRM - Permanent Reference Monument	PSM - Professional Surveyor & Mapper PT - Point of Tangency PUE - Public Utility Easement R - Radius or Radial R/W - Right of Way RES - Residential RGE - Range ROE - Roof Overhang Easement RP - Radius Point S/W - Sidewalk SBL - Setback Line SCL - Survey Closure Line SCR - Screen SEC - Section SEP - Septic Tank SEW - Sewer SIRC - Set Iron Rod & Cap SMWE - Storm Water Management Easement SN&D - Set Nail and Disc SQFT - Square Feet STL - Survey Tie Line STY - Story SV - Sewer Valve SWE - Sidewalk Easement TBM - Temporary Bench Mark TEL - Telephone Facilities TOB - Top of Bank TUE - Technological Utility Easement TWP - Township TX - Transformer TYP - Typical UE - Utility Easement UG - Underground UP - Utility Pole UR - Utility Riser VF - Vinyl Fence W/C - Witness Corner W/F - Water Filter WF - Wood Fence WM - Water Meter/Valve Box WV - Water valve
---	---

- JOB SPECIFIC SURVEYOR NOTES:
1. Subject to drainage easement extending 15 feet on each side of the centerline of any and all natural drainage courses per the Regulations of Harris County, Texas for the Approval and Acceptance of Infrastructure. No natural drainage courses were observed during our survey.

2. This survey was prepared with information contained in Title Commitment GF No. TX-44592 of Title Forward Title Company, effective date of July 16, 2021, issued date of July 27, 2021, and is subject to the limitations of that commitment.

3. Subject to easements and setbacks as per restrictions recorded in Schedule B, Item No. 10f.

4. All building lines and easements shown hereon are per the record plat, unless otherwise noted.

5. Schedule B, Item No. 10g (Applies as shown on survey).

Headquarter's Office
o: 866.735.1916 | f: 866.744.2882
1955 Lakeway Drive, Ste 220 | Lewisville, TX 75057
Firm No: 10063800

Branch Office
o: 866.735.1916 | f: 866.744.2882
11111 Richmond Ave, Suite 150 | Houston, TX 77082
Firm No: 10194357

SEE PAGE 1 OF 2 FOR MAP OF PROPERTY
PAGE 2 OF 2 - NOT VALID WITHOUT ALL PAGES