



1. HORIZONTAL CONTROL FOR THIS SURVEY IS BASED ON GPS NAD 83 TEXAS CENTRAL ZONE STATE PLANE COORDINATES.
2. ADJOINER INFORMATION IS FROM THE GRIMES COUNTY APPRAISAL DISTRICT WEB SITE.
3. TITLE AND EASEMENT INFORMATION SHOWN HEREON IS THE RESPONSIBILITY OF OTHERS.
THE SURVEYOR DOES NOT ACCEPT RESPONSIBILITY FOR ANY OF THE INFORMATION NOR ANY DECISIONS LEADING TO THE NOTING OF SAID INFORMATION.

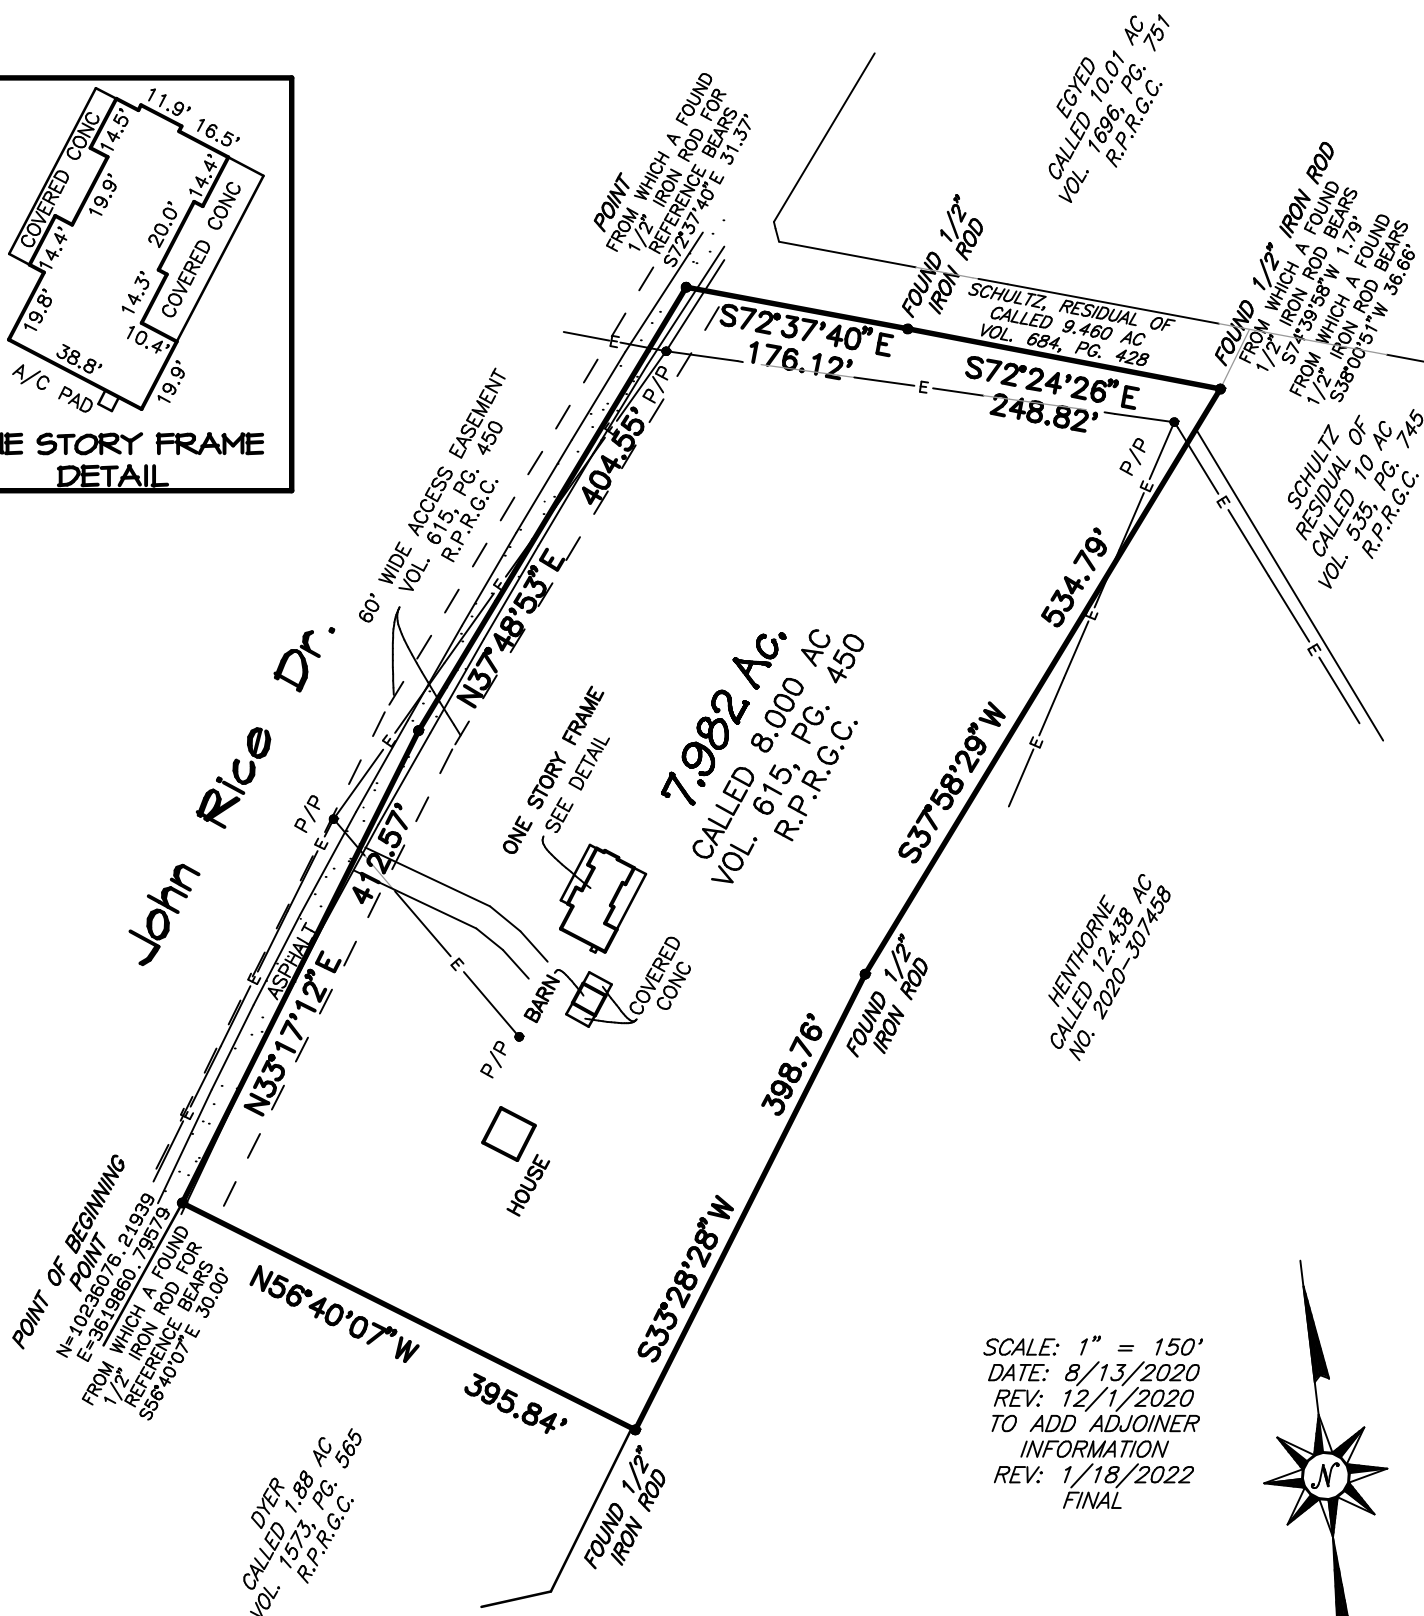

SCALE: 1" = 150'
DATE: 8/13/2020
REV: 12/1/2020
TO ADD ADJOINER
INFORMATION
REV: 1/18/2022
FINAL

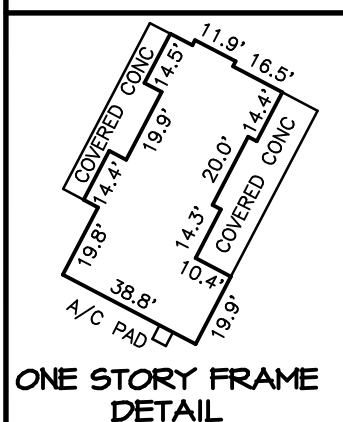

A SURVEY OF
7.982 ACRES

IN THE ROBERT ARMOUR SURVEY, A-1
GRIMES COUNTY, TEXAS

I hereby certify that this survey was made on the ground under my supervision that this drawing correctly represents the facts found at the time of this survey and that this professional service substantially conforms to the current Texas Surveyors Association Standards and Specifications for a Category 1B survey.

This survey was completed without the benefit of a title commitment.

~~Jarrold Antley, R.P.L.S.~~
~~Texas Registration No. 6071~~

