

Plat of Survey

of
Lot 1 of Certified Survey Map No. 3504,

recorded November 22, 2002 in Vol. 20 of Certified Survey Maps of Walworth County on Page 232 as Document Number 532956 and located in the Northeast 1/4 and the Southeast 1/4 of the Northwest 1/4 of Section 13, Town 2 North, Range 15 East, Town of Darien, Walworth County, Wisconsin.
EXCEPTING THEREFROM lands conveyed to the State of Wisconsin, Department of Transportation by Doc. No. 947158.

and

Lot 1 of Certified Survey Map No. 3832,

recorded August 31, 2005 in Vol. 23 of Certified Survey Maps of Walworth County on Page 147 as Document Number 651951 and located in the Northeast 1/4 and the Southeast 1/4 of the Northwest 1/4 of Section 13, Town 2 North, Range 15 East, Town of Darien, Walworth County, Wisconsin.
EXCEPTING THEREFROM lands conveyed to the State of Wisconsin, Department of Transportation by Doc. No. 947159.

and

Lot 1 of Certified Survey Map No. 5233,

recorded December 23, 2025, as Document Number 1122663 and located in the Northeast 1/4 and the Southeast 1/4 of the Northwest 1/4 of Section 13, Town 2 North, Range 15 East, Town of Darien, Walworth County, Wisconsin.

and

Tax Parcel BD 1300005

located in the Northeast 1/4 and the Southeast 1/4 of the Northwest 1/4 of Section 13, Town 2 North, Range 15 East, Town of Darien, Walworth County, Wisconsin.

Description of Record


A parcel of land described in a Warranty Deed recorded April 16, 2020 as Document No. 1007639 as shown below:
Parcel B D 1300005
A parcel of land located in the East 1/2 of the Northwest 1/4 of Section 13, Town 2 North, Range 15 East, Town of Darien, Walworth County, Wisconsin described as follows: Commencing at the Southwest corner of Hiemstra's Subdivision in the centerline of State Trunk Highway No. 11, thence North 74° 58' 00" West along said centerline 129.00 feet, thence North 13° 59' 00" East 320.00 feet to the Northeast corner of Lot 1 of Certified Survey No. 579, recorded in Volume 3, page 33 of Certified Surveys in the office of the Register of Deeds in Walworth County, Wisconsin and the place of beginning, thence continue North 13° 59' 00" East 1003.60 feet, thence North 76° 15' 00" West 660.00 feet to the West line of said East 1/2 of the Northwest 1/4 of said Section 13 as fenced, thence South 0° 25' 00" East along said West line as fenced 1037.43 feet to the Northwest corner of the aforementioned Lot 1 of Certified Survey No. 579, thence South 76° 36' 00" East along the Northerly line of said Lot 1, 401.80 feet to the place of beginning.
ALSO, A parcel of land located in the Northwest 1/4 of Section 13, Town 2 North, Range 15 East, Town of Darien, Walworth County, Wisconsin, described as follows: Beginning at the Southwest corner of Hiemstra's Subdivision in the centerline of State Trunk Highway No. 11, thence North 74° 58' 00" West along said centerline 129.00 feet; thence North 13° 59' East 391.02 feet; thence South 83° 49' East 36.65 feet to the Northwest corner of Lot 2 of said Hiemstra's Subdivision; thence South 0° 52' West along the West line of said subdivision 409.04 feet to the place of beginning.
EXCEPTING THEREFROM land conveyed to the State of Wisconsin, Department of Transportation in Warranty Deed dated April 5, 2017 and recorded April 20, 2017 as Document No. 944855.
EXCEPTING THEREFROM land conveyed in a Quit Claim Deed recorded December 23, 2025 as Document No. 1122659 described as follows: A parcel of land located in the Northeast 1/4 and the Southeast 1/4 of the Northwest 1/4 of Section 13, Town 2 North, Range 15 East, Town of Darien, Walworth County, Wisconsin, described as follows: Begin at an iron pipe at the Northwest Corner Lot 2 of Hiemstra's Subdivision; thence South 0° 18' 53" East, along the West line of Lot 1 and 2 of said Hiemstra's Subdivision, 357.43 feet to an iron pipe on the Northerly line of State Trunk Highway 11; thence North 76° 08' 55" West, along said Northerly line, 58.63 feet to an iron pipe; thence North 12° 45' 45" East 105.00 feet to an iron pipe; thence North 2° 25' 16" East 243.08 feet to an iron pipe; thence South 85° 00' 08" East, along the Westerly extension of the North line of said Lot 2 of Hiemstra's Subdivision, 21.57 feet to the Point of Beginning.

Tax Parcel BD 1300005 and Tax Parcel BA523300001,

Surveyed for: **Roger & Karen Wuttke**
W7560 Pleasant Street
Delavan, Wisconsin. 53115


Tax Parcel BA350400001 and Tax Parcel BA383200001,

Surveyed for: **R & R Ventures, LP**
P.O. Box 628
Darien, Wisconsin. 53114

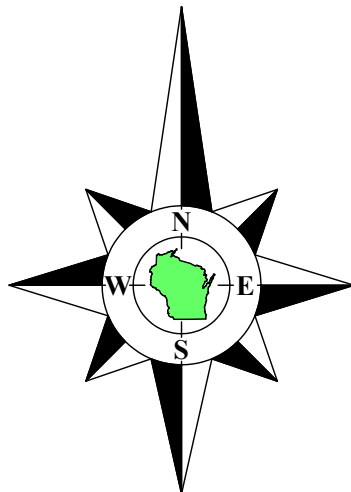


Bearings referenced to the South line of the Northwest 1/4 of Section 13-2-15, recorded as N87°25'57"E in the Wisconsin State Plane Coordinate System, South Zone, (NAD-27).

Coordinates are referenced to the Wisconsin State Plane Coordinate System, South Zone, (NAD-27).

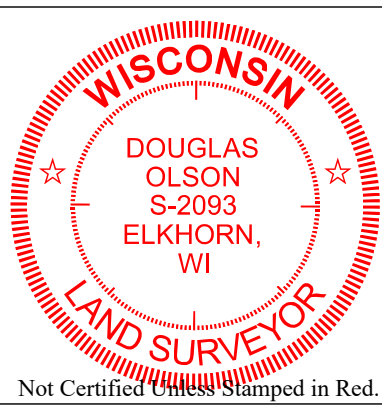

Notes:

- This Plat of Survey is not certified unless signed and sealed in red ink.
- This survey is subject to Wisconsin lien laws. This Plat of Survey is the notice of intent to file lien. Lien waiver required.
- The Survey Date shown on this Plat of Survey is the completion date of the field work.

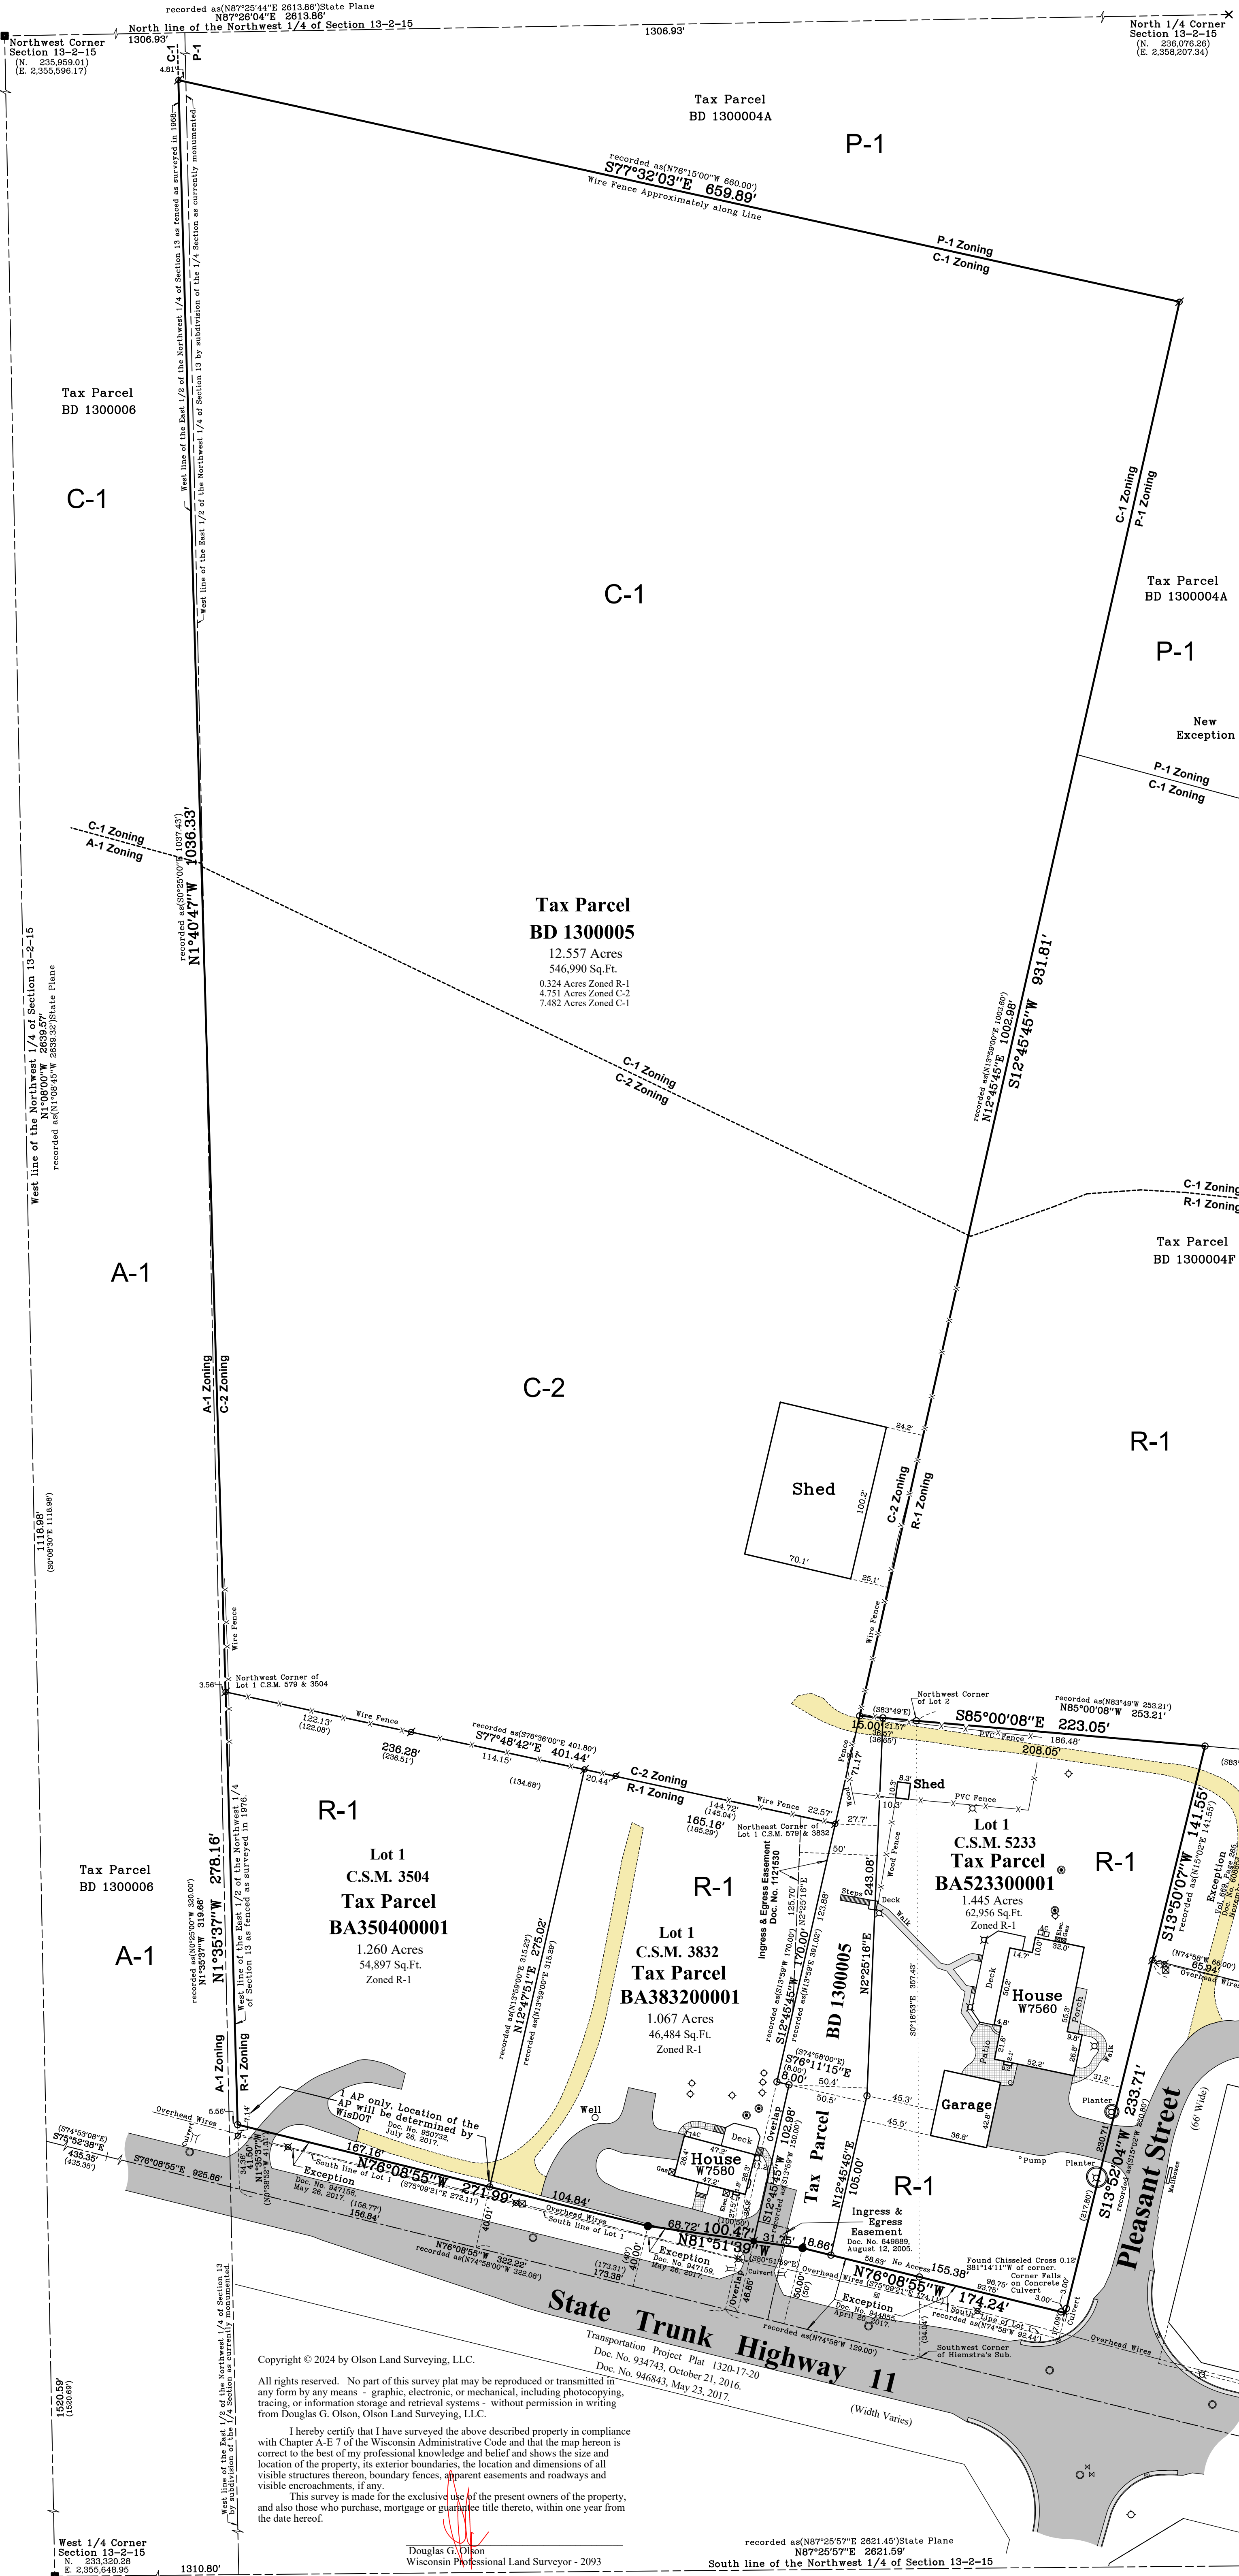

Copyright © 2024 by Olson Land Surveying, LLC.

All rights reserved. No part of this survey plat may be reproduced or transmitted in any form by any means - graphic, electronic, or mechanical, including photocopying, tracing, or information storage and retrieval systems - without permission in writing from Douglas G. Olson, Olson Land Surveying, LLC.

I hereby certify that I have surveyed the above described property in compliance with Chapter A-E 7 of the Wisconsin Administrative Code and that the map hereon is correct to the best of my professional knowledge and belief and shows the size and location of the property, its exterior boundaries, the location and dimensions of all visible structures thereon, boundary fences, apparent easements and roadways and visible encroachments, if any.

This survey is made for the exclusive use of the present owners of the property, and also those who purchase, mortgage or guarantee title thereto, within one year from the date hereof.

Douglas G. Olson
Wisconsin Professional Land Surveyor - 2093

Legend

- Found County Section Corner
- Found Iron Pipe
- Found Iron Rod with WDO Cap
- Recorded Information
- Utility Pole
- Utility Pedestal
- Concrete Cover
- Septic Vent
- Asphalt Surface
- Concrete Surface
- Gravel Surface
- Brick Pavers
- Found Concrete Monument
- Set Mag Nail
- Light Pole or Lamp
- Catch Basin
- Water Valve
- Manhole
- Access Point

N North
S South
E East
W West
In Bearings
Degrees
Minutes
Seconds
In Distances
Feet
Inches
Number
NW Northwest
NE Northeast
SE Southeast
SW Southwest
AP Access Point



45 South Wisconsin Street | P.O. Box 322
Elkhorn, Wisconsin. 53121
Telephone: (262) 723-3434
Facsimile: (262) 723-8044
Email: doug@olsonsurveying.com
Website: www.olsonsurveying.com

Scale in Feet

1" = 50'



Survey Date: December 20, 2024.

Revisions: No. 1 - Proposed Lot Line Adjustment
No. 2 - Descriptions
No. 3 - Recorded Quit Claim Deed & Certified Survey Map

2024.081
2024.082

Sheet 1 of 1 Sheets

Drawing Name:

Job Reference Number
2024.081 & 2024.082