Services Offered
Commercial Site Development
Subdivision Design and Platting
Planning and Plan Review
Streets and Highway Design
Drainage Studies
Water Distribution Systems
Sewer Collection Systems
Construction Surveying and Stake-out Services
GPS Surveying
Certified Soil Testing

Nienow Engineering Assoc.
Consulting Engineers and Surveyors
5555 N. Port Washington Road
Milwaukee, WI 53217
(414) 963-4022 Fax (414) 963-4028

PROJ. NO. 962966
962966R1

PLAT OF SURVEY

PREPARED FOR: JEROME J. AND CECIL A. MURPHY

LEGAL DESCRIPTION:
BEING A PART OF THE SOUTHWEST 1/4 OF THE NORTHEAST 1/4 OF SECTION 20, TOWNSHIP 7 NORTH, RANGE 18 EAST, IN THE ~~TOWN~~ City OF DELAFIELD, WAUKESHA COUNTY, WISCONSIN.

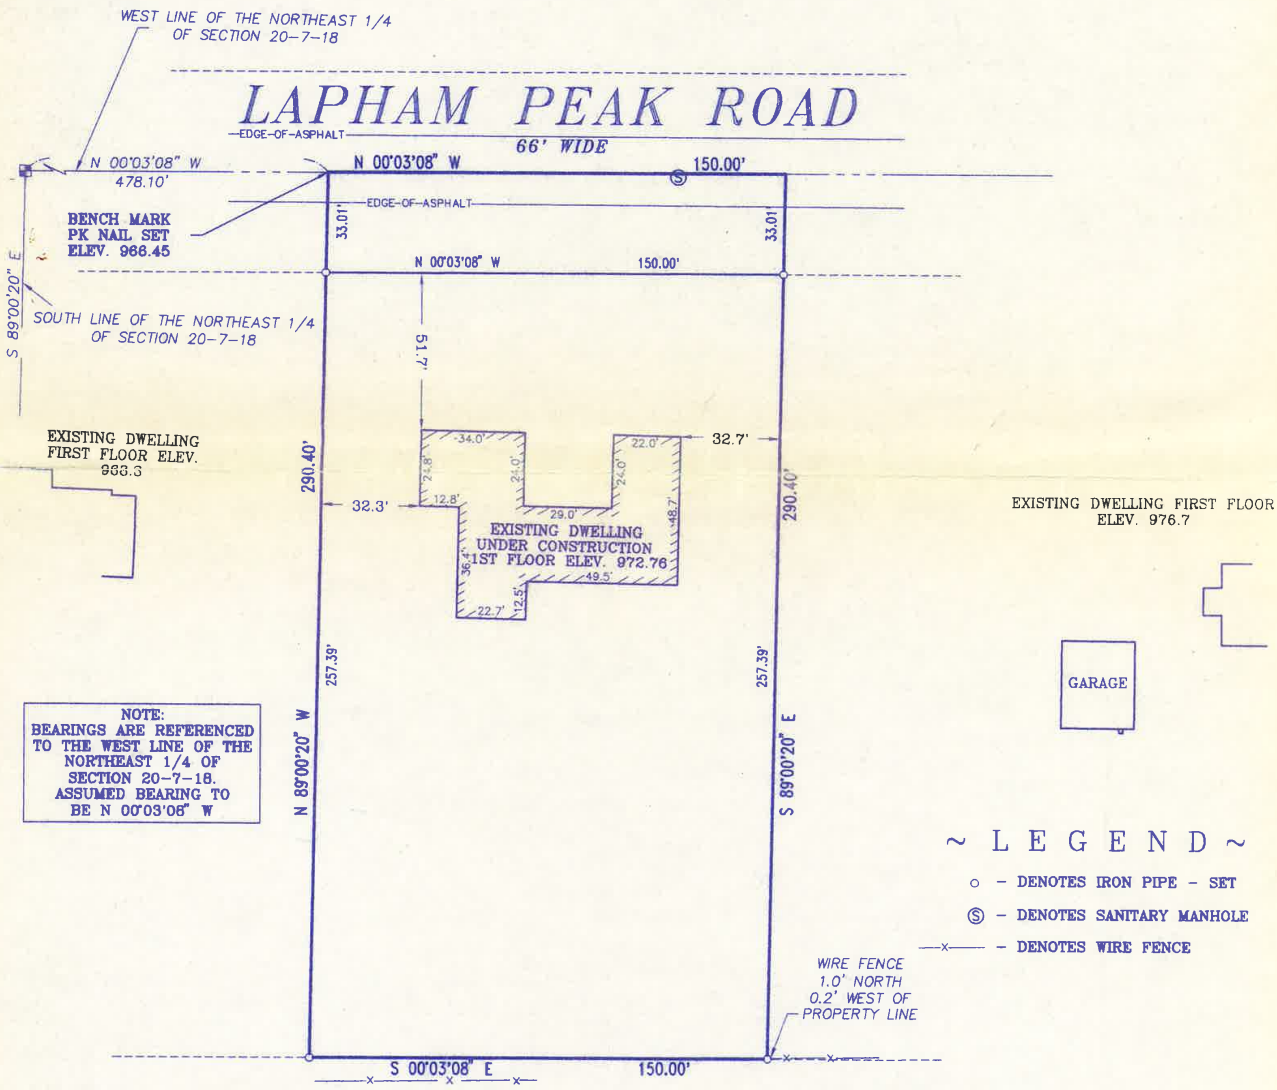

NOTE:
BEARINGS ARE REFERENCED TO THE WEST LINE OF THE NORTHEAST 1/4 OF SECTION 20-7-18. ASSUMED BEARING TO BE N 00°03'08" W

~ L E G E N D ~

- o – DENOTES IRON PIPE – SET
- Ⓢ – DENOTES SANITARY MANHOLE
- —x— – DENOTES WIRE FENCE

REVISED 8/27/97 – PROPOSED BUILDING

SCALE 1" = 40'

STATE OF WISCONSIN)
MILWAUKEE COUNTY)

I hereby certify that I have surveyed the above described property and the above map is a true representation thereof and shows the size and location of the property, its exterior boundaries, the location of all visible structures and dimensions of all principal buildings thereon, boundary fences, apparent easements, roadway and visible encroachments, if any.

This survey is made for the present owners of the property, and also those who purchase, mortgage, or guarantee, the title thereto within (1) year from date hereof.

Dated at MILWAUKEE, WI, this 27TH day of SEPTEMBER, 19 96

OCTOBER 25, 1997

WISCONSIN
MARK D. NESBOOD
S-1967
KENOSHA, WI